RECORDED JUNE 29, 2001 BK 424 PG 646 NO 379853 AUDREY KOLTISKA, COUNTY CLERK

RIGHT OF WAY AGREEMENT

KNOW ALL MEN BY THESE PRESENTS: that the undersigned (hereinafter referred to as "OWNER", whether one or more), for and in consideration of Ten and More Dollars (\$10.00+) in hand paid, the receipt of which is hereby acknowledged, does hereby grant, sell and convey unto Bear Paw Energy, LLC, 370 17th Street, Suite 2775, Denver, Colorado 80202-1370, its successors and assigns (hereinafter referred to as "COMPANY") a right of way and easement Fifty feet (50') in width for the purpose of laying, constructing, maintaining, operating, replacing and removing gas pipeline(s) (with fittings cathodic protection equipment and all appliances appurtenant thereto) for the transportation of oil, gas or any other liquids or substances for COMPANY'S operations across lands of OWNER, situated in the County of Sheridan, State of Wyoming, described as follows:

Township 58 North Range 83 West Section 35: SE

Township 57 North Range 83 West Section 02: All Section 11: NE

OWNER recognizes that an as built plat, subsequent to survey, is attached hereto and recorded as Exhibit "A".

COMPANY shall bury the top of its pipe at least forty-eight inches (48") below the surface of the ground. The undersigned OWNER, his successors, heirs or assigns, reserves all oil, gas and minerals on and under said lands and the right to farm, graze and otherwise fully use and enjoy said lands, provided, however, that COMPANY shall have the right hereafter to cut and keep clear all trees, brush, and other obstructions that may injure, endanger or interfere with the construction and use of said pipeline, or fittings, tie-overs, cathodic protection equipment and appliances appurtenant thereto. COMPANY shall have all privileges necessary or convenient for the full use of the rights herein granted, together with ingress or egress along with pipelines and over and across said lands. COMPANY, by acceptance hereof, agrees to pay for actual damages to crops, pasture, fences and timber which may arise from laying, construction, maintaining, operating, replacing, or removing said pipeline(s).

COMPANY agrees to comply with all applicable state and local regulations.

COMPANY shall indemnify, defend and save and hold harmless OWNER from any and all claims, demands, causes of action, or liability for damages, loss or injuries that arise out of COMPANY'S operations on the land.

COMPANY shall restore the land as soon as practicable after the pipclines are completed. Restoration shall be made as near as possible to the condition when COMPANY first entered onto the land.

OWNER hereby warrants and agrees to defend the title to the above-described premises. OWNER shall have the use of such right of way and easement except for any use which conflicts with the purposes for which this right of way and easement is granted; provided, however, OWNER shall not build or construct nor permit to be built or constructed any building or other improvement over or across said right of way and easement.

TO HAVE AND TO HOLD said right of way and easement unto said COMPANY, its successors and assigns, until such pipelines are constructed and so long thereafter as a pipeline is maintained thereon; and the undersigned hereby bind themselves, their heirs, executors, administrators, successors and assigns, against every person whomsoever lawfully claiming or to claim the same, or any part thereof.

Executed this 10th day of November, 2000

OWNER:

Anna Pilch, Individually and as Trustee of the Anna Pilch Agreement of Trust, dated July 23, 1985

BY: Anna Pilch, Individually and as

Trustee of the Anna Pilch Agreement of Trust,

dated July 23, 1985

COMPANY: Bear Payv-Energy, LL

BY: Don H. Littleton, agent

ACKNOWLEDGEMENT

STATE OF WYOMING)) ss. COUNTY OF SHERIDAN)	
The foregoing instrument was acknowledged before me this and as Trustee of the Anna Pilch Agreement of Trust, dated July 23,	10th day of November, 2000 by Anna Pilch, Individually
Witness my hand and official seal.	Notary Public K. Breen
My commission expires: <u>Ataber 13, 2004</u>	JENNIFER K. GREEN - NOTARY PUBLIC County of State of Sheridan Wyoming My Commission Expires Oct. 13, 2004
STATE OF WYOMING)) ss. COUNTY OF SHERIDAN)	
The foregoing instrument was acknowledged before me th agent for Bear Paw Energy LLC.	is 10th day of November, 2000 by Don H. Littleton, as
Witness my hand and official seal.	Jennife K. Breen
My commission expires: Lataber 13, 2004	JENNIFER K. GREEN - NOTARY PUBLIC County of State of Sheridan Wyoming My Commission Expires Oct. 13, 2004



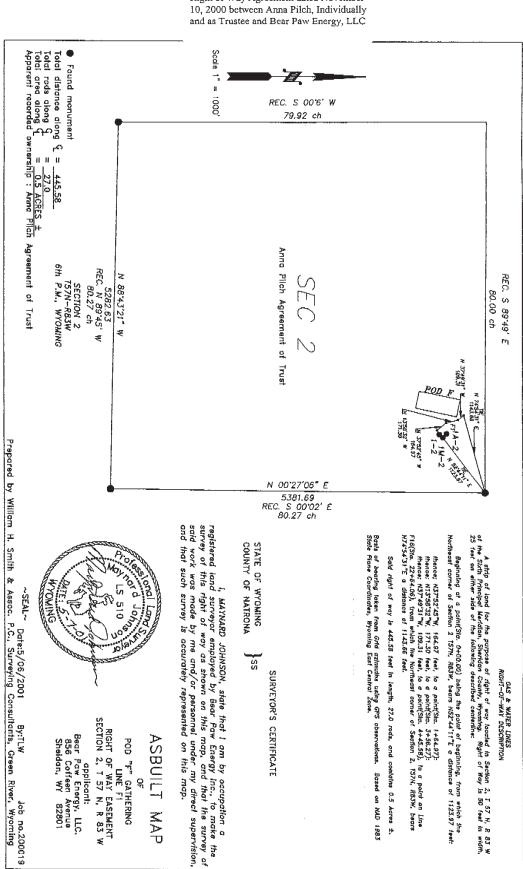


Exhibit "A" attached to and made a part of Right of Way Agreement dated November

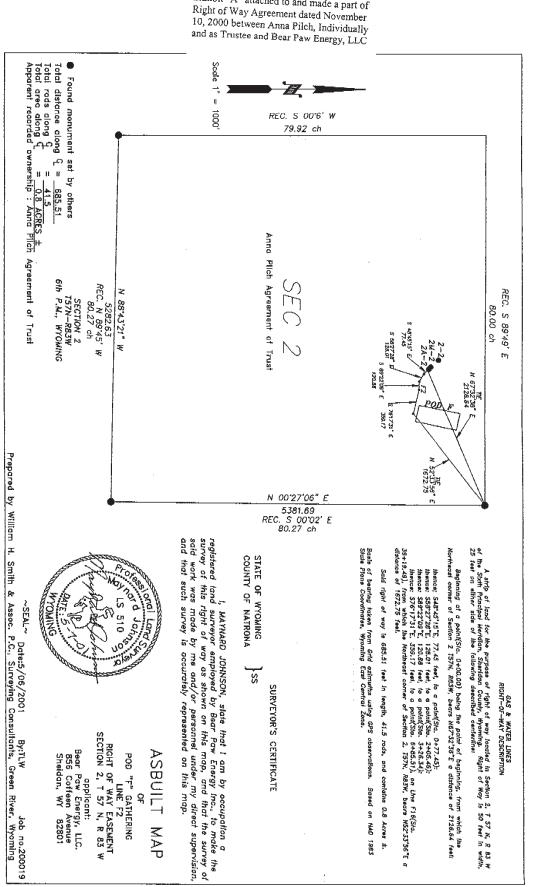

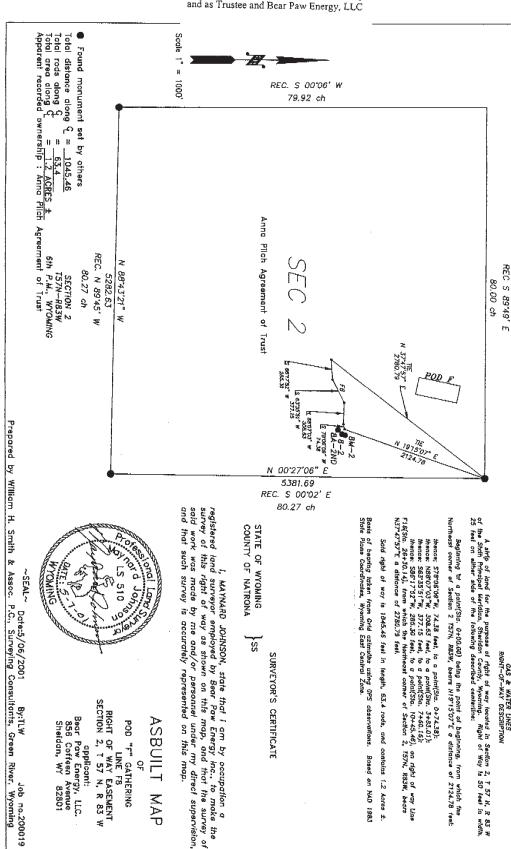

GAS & WATER LINES RIGHT-OF-WAY DESCRIPTION

A strip of land for the purpose of right of way located in Section 2, T. 57 N. R. 83 W. of the Shith Principal Keridian, Sheridan County, Wycaning. Right of Way is 50 feet in width, 25 feet on either side of the following described centerline:

Beginning to a point(Sta. 0+00.00) being the point of beginning, from which the Northeast comer of Section 2 TS7N, R83W, bears N19"15"07"E a distance of 2124-78 feet.


Basis of bearing taken from Grid azimuthe using GPS abservations. Based on NAD 1983 State Plane Coordinates, Wyoming East Central Zone. Said right of way is 1845.46 feet in length, 63.4 rads, and contains 1.2 Acres ±.

I, MAYNARD JOHNSON, state that I am by occupation a registered land surveyor employed by Bear Paw Energy Inc., to make the survey of this right of way as shown on this map, and that the survey of said work was made by me and/or personnel under my direct supervision, and that such survey is accurately represented on this map.

ASBUILT MAP

POD "F" GATHERING
LINE F8
RIGHT OF WAY EASEMENT
SECTION 2, T 57 N, R 83 W ≼

applicant:
Bear Paw Energy, LLC.
856 Coffeen Avenue
Sheidan, WY 82801

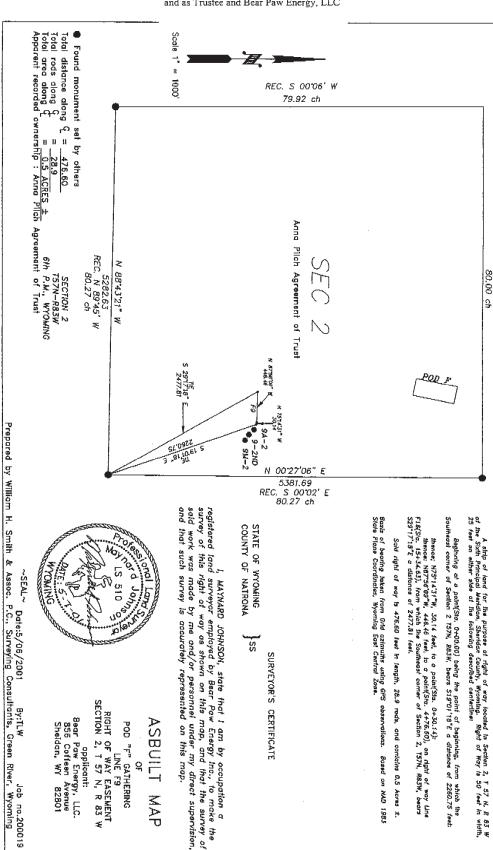

GAS & WATER LINES RIGHT-OF-WAY DESCRIPTION

\$ 89.49 m

A strip of land for the purpose at right of way located in Section 2, T 57 N, R 83 W of the Sixth Principal Mendian, Sheridan County, Wyoming. Right of Way is 50 feet in width, 25 feet on either side at the following described centerline:

Beginning at a point(Sta. 0+00.00) being the point of beginning, from which the Southeast corner of Section 2 TSTN, RBJK, bears 519"01"18"E a distance of 2260.75 feets

thence; N/351471*N, 30.14 feet, to a point(Sta. 0+30.14);
thence: N8756'03"N, 446.45 feet, to a point(Sta. 4+76.60), on right of way Une f18(Sta. 15+14.61), from which the Southeast corner of Section 2, 137N, R83W, bears \$29'17'18"E a distance of 2477.81 feet.

Sold right of way is 476.60 feet in length, 28.9 rods, and contains 0.5 Acres ±.

Basis of bearing taken from Grid azimuths using GPS observations. Based on MAD 1983 State Plane Coordinates, Wyoming East Central Zose.

SS SURVEYOR'S CERTIFICATE

I, MAYNARD JOHNSON, state that I am by occupation a registered land surveyor employed by Bear Paw Energy Inc., to make the survey of this right of way as shown on this map, and that the survey of said work was made by me and/or personnel under my direct supervision, and that such survey is accurately represented on this map.


ASBUILT MAP


OF POD "F" GATHERING LINE F9

opplicant: Bear Paw Energy, LLC. 856 Coffeen Avenue Sheidan, WY 82801

RIGHT OF WAY EASEMENT SECTION 2, T 57 N, R 83 W

Exhibit "A" attached to and made a part of Right of Way Agreement dated November

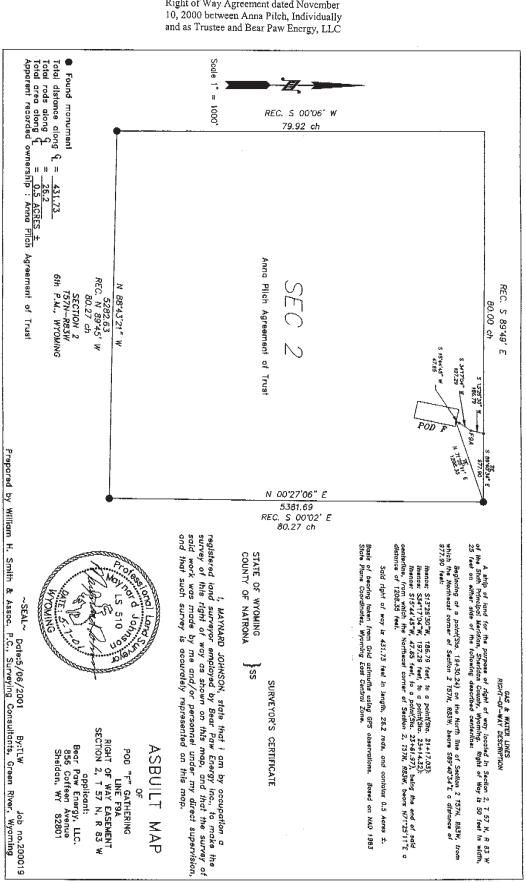

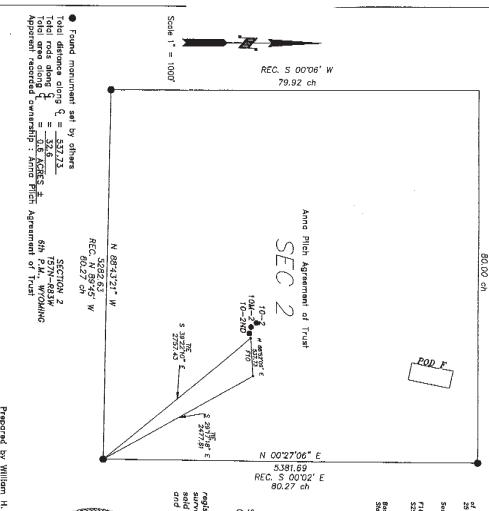

GAS & WATER LINES RIGHT-OF-WAY DESCRIPTION

REC. S 89'49'

ш

A strip of land for the purpose of right of way located in Section 2, T 57 H, R 83 W of the Sixth Principal Meridian, Sheridan County, Wyoming. Right of Way is 50 feet in width, 25 feet on either side of the following described certerlines.

Beginning at a point(Sta. 0+00.00) being the potat of beginning, from which the southeast corner of Section 2 157M, R83M, bears 539°22′10″E a distance of 2757.43 feet

thence; NBC*52'09°E, 537.73 feet, to a polet(Sta. 5+37.73), an right of way Line F16(Sta. 15+34.63), from which the Southwest corner of Section Z. 157K, R33W, bears \$23'17'18'E a distance of 247.81' feet.

Basis of bearing taken from Grid azimuths using GPS observations. Based on NAD 1983 State Plane Coordinates, Wyoming East Central Zone. Said right of way is 537.73 feet in length, 32.6 rods, and contains 0.6 Acres £.

COUNTY OF NATRONA STATE OF WYOMING SS

SURVEYOR'S CERTIFICATE

I, MAYNARD JOHNSON, state that I am by occupation a registered land surveyor employed by Bear Paw Energy Inc., to make the survey of this right of way as shown on this map, and that the survey of said work was made by me and/or personnel under my direct supervision, and that such survey is accurately represented on this map.



ASBUILT MAP


POD "F" GATHERING
LINE F10
RIGHT OF WAY EASEMENT
SECTION 2, 1 57 N, R 83 W


applicant: Bear Paw Energy, LLC. 856 Coffeen Avenue Sheldan, WY 82801

Prepared by William H. Smith & Assoc. P.C., Surveying Consultants, Green River, Wyoming ~SEAL~

Ę, ".º.,

 $\Gamma_{c,j}$

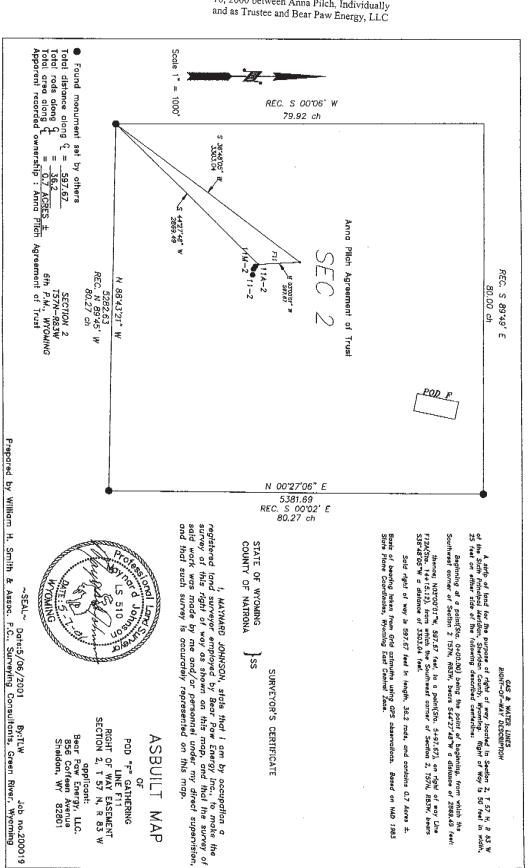

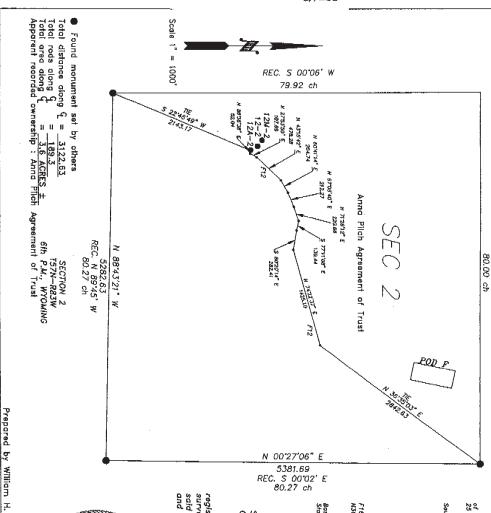

GAS & WATER LINES RIGHT-OF-WAY DESCRIPTION

REC.

\$ 89*49*

A ship of land for the purpose of right of way tocoffed in Serbon 2, I 57 M, R 83 M of the Static Principal Meridian, Sheridan County, Myomkig. Right of Way is 50 feet in Width, 25 feet on either sides of the following described entertine:

Beginning at a point(Sta. 9+00.00) being the point of beginning, from which the Southwest corner of Section 2 T57N, R83W, bears 522°45°49°W a distance of 2145.17 feet.

Hence: N86"35'38"E, 52.04 feet, lo a point(Sin. 0+52.04); hance: N27"55'50'E, 107.59 feet, to a point(Sin. 1+52.73); hance: N42"55'25'E, 478.28 feet, to a point(Sin. 8+82.73); hance: N60"41'14'E, 204.74 feet, to a point(Sin. 8+42.75); hance: N60"41'14'E, 272.27 feet, to a point(Sin. 8+42.75); hance: N71"10'8'E, 132.44 feet, to a point(Sin. 12+75.68); hance: N71"10'8'E, 139.44 feet, to a point(Sin. 14+5.12); hance: N74"22"37"E, 1425.10 feet, to a point(Sin. 14+5.13); and the N60"25'14'E, 282.41 feet, to a point(Sin. 15+27.53); hance: N74"22"37"E, 1425.10 feet, to a point(Sin. 3+42.63); and feet, so a point(Sin. 3+22.63); and feet, so a Said right of way is 3122.63 feet in length, 189.3 rods, and contains 3.6 Acres ± , to a point(Sta. 31+22,63), on right of way Line theast corner of Section 2, 757N, .R83W, bears

Basis of bearing taken from Grid azimuths using GPS observations. Based on NAD 1983 State Plane Coordinates, Wyoming East Central Zone.

SURVEYOR'S CERTIFICATE

STATE OF WYOMING COUNTY OF NATRONA SS

I, MAYNARD JOHNSON, state that I am by occupation a registered land surveyor employed by Bear Paw Energy inc., to make the survey of this right of woy as shown on this map, and that the survey of said work was made by me and/or personnel under my direct supervision, and that such survey is accurately represented on this map.




ASBUILT MAP


RIGHT OF WAY EASEMENT SECTION 2, T 57 N, R 83 W applicant: Bear Paw Energy, LLC. B56 Coffeen Avenue Sheidan, WY 82801 POD "F" GATHERING LINE F12

Prepared by William H. Smith & Assoc. P.C., Surveying Consultaris, Green River, Wyoming ~SEAL~

مال م

Exhibit "A" attached to and made a part of Right of Way Agreement dated November 10, 2000 between Anna Pilch, Individually and as Trustee and Bear Paw Energy, LLC

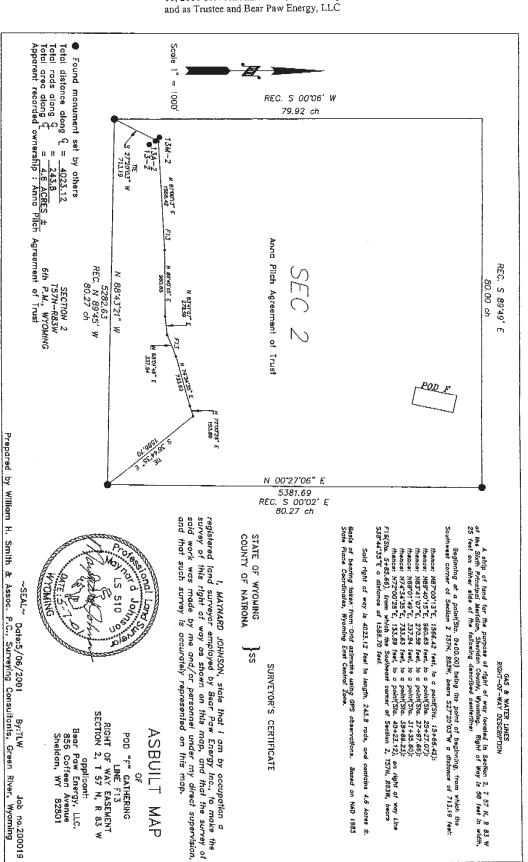

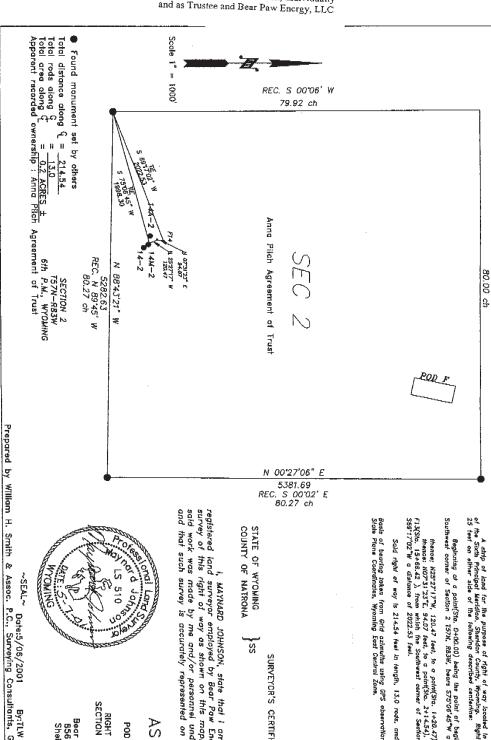

GAS & WATER LINES
RIGHT-OF-WAY DESCRIPTION

REC. S 89°49' E

A ship of land for the purpose of right of way located to Section 2, 7 57 M, R 83 W of the Stath Petrologia Maridian, Sheetdon County, Wordings, Right of Way to 80 feet in width 25 feet on either side of the following described enterline:

Beginning at a point(Sta. 0+00.00) being the point of beginning, from which the Southwest corner of Section 2 157N, RB3H, bears 575'06'45"N a distance of 1998.30 feet.

thence; N25'27'17"W, 120.47 feet, to a point(Sta. 1+20.47):
thence: N07'51'23"E, 94.07 feet, to a point(Sta. 2+14.54), on right of way Line
F13(Sta. 15+68.42,), from which the Southwest corner of Section 2, 1757N, R83'K, bears
\$69'17'02"W a distance of 2022.53 feet.

Basis of bearing joken from Grid azimuths using GPS observations. Based on HAD 1983 State Plane Coordinates, Hyoming East Central Zone. Sold right of way is 214.54 feet in length, 13.0 rads, and contains 0.2 Agres t.

SS

SURVEYOR'S CERTIFICATE

I, MAYNARD JOHNSON, state that I am by occupation a registered land surveyor employed by Bear Paw Energy Inc., to make the survey of this right of way as shown on this map, and that the survey of said work was made by me and/or personnel under my direct supervision, and that such survey is accurately represented on this map.




ASBUILT MAP 읶


POD "F" GATHERING
LINE F14
RIGHT OF WAY EASEMENT
SECTION 2, T 57 N, R 83 W opplicant: Bear Paw Energy, LLC. B56 Coffeen Avenue Sheidan, WY 82801

W Job no.200019 Green River, Wyoming

[::5]

Exhibit "A" attached to and made a part of Right of Way Agreement dated November

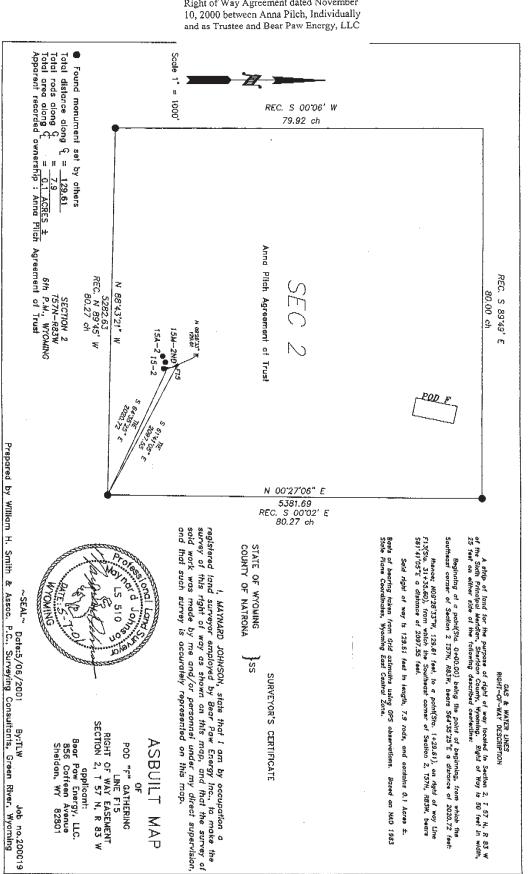

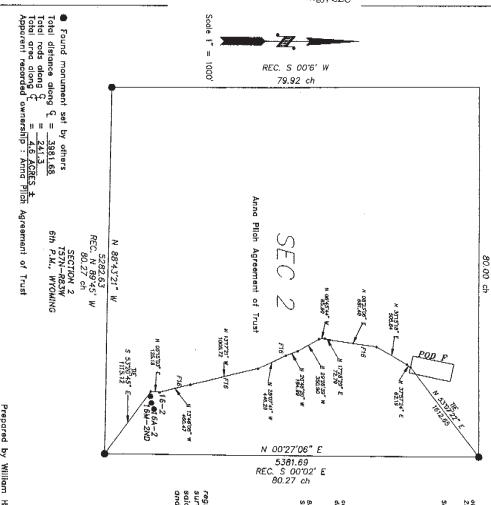

GAS & WATER LINES RIGHT-OF-WAY DESCRIPTION

REC. S 89"49"

A strip of land for the purpose of right of way located in Section 2, T 57 H, R 83 W of the Sixth Principal Meridian. Sheridan County, Myoming. Right of Way is 50 feet in width, 25 feet on either side of the following described centertines:

Beginning at a point(Sta. 0+00.00) being the point of beginning, from which the Southeast comer of Section 2 TSTN, R83W, bears 553*20*45*E a distance of fi15.12 feet

thence: NOS*15*03*E, 125.19 feet, to a point(Sta. 1+25.19); thence: NI3*48*06*W, 460.47 feet, to a point(Sta. 15+81.38); thence: NI3*48*06*W, 460.47 feet, to a point(Sta. 15+81.38); thence: NI3*07*47*W, 448.29 feet, to a point(Sta. 20+37.67); thence: NI3*07*47*W, 448.29 feet, to a point(Sta. 20+37.65); thence: NI3*07*872*W, 350.40 feet, to a point(Sta. 20+37.56); thence: NI3*07*872*W, 350.40 feet, to a point(Sta. 25+34.66); thence: NI4*728*32*F, 72.79 feet, to a point(Sta. 25+34.65); thence: NI4*728*32*F, 32.79 feet, to a point(Sta. 35+34.35); thence: NI3*07*12*6*C, 351.40 feet, to a point(Sta. 35+13.53); thence: NI3*07*12*6*C, 351.40 feet, to a point(Sta. 35+13.85) long the end of self-tile, from which the Northeast corner of Section 2, 157N, RBJW, bears NI3*07*22*C a distance of 1612.55 feet.

Basks of bearing taken from Grid extinuths using GPS observations. Bassd on NAD 1983 State Plane Coordinates, Wyoming East Central Zone. Said right of way is 3981.58 feet in length, 241.3 rods, and contains 4.6 Acres &

SURVEYOR'S CERTIFICATE

STATE OF WYOMING COUNTY OF NATRONA SS

I, MAYNARD JOHNSON, state that I am by occupation a registered land surveyor employed by Bear Paw Energy Inc., to make the survey of this right of way as shown on this map, and that the survey of said work was made by me and/or personnel under my direct supervision, and that such survey is accurately represented on this map.



ASBUILT MAP

RIGHT OF WAY EASEMENT SECTION 2, T 57 N, R 83 V OF
POD "F" GATHERING
LINE F16

applicant: Bear Paw Energy, LLC. 856 Coffeen Avenue Sheidan, WY 82801

Prepared by William H. Smith & Assoc. P.C., Surveying Consultants, Green River, Wyoming SEAL~

